

Ordinance #244 requirements are now met.


DEVELOPMENT PLAN REVIEWED (Not for Construction) # 1100

Screening & Landscaping to be provided as per Ord. #244


St. *supla* 4/16/85

CITY OF LOUISVILLE DEPARTMENT OF PUBLIC WORKS

supla 2/14/85 DATE

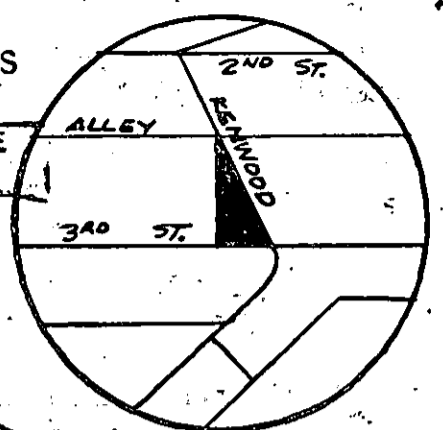

DENIED
DATE *April 18, 1985*
BY LOUISVILLE AND JEFFERSON COUNTY PLANNING COMMISSION

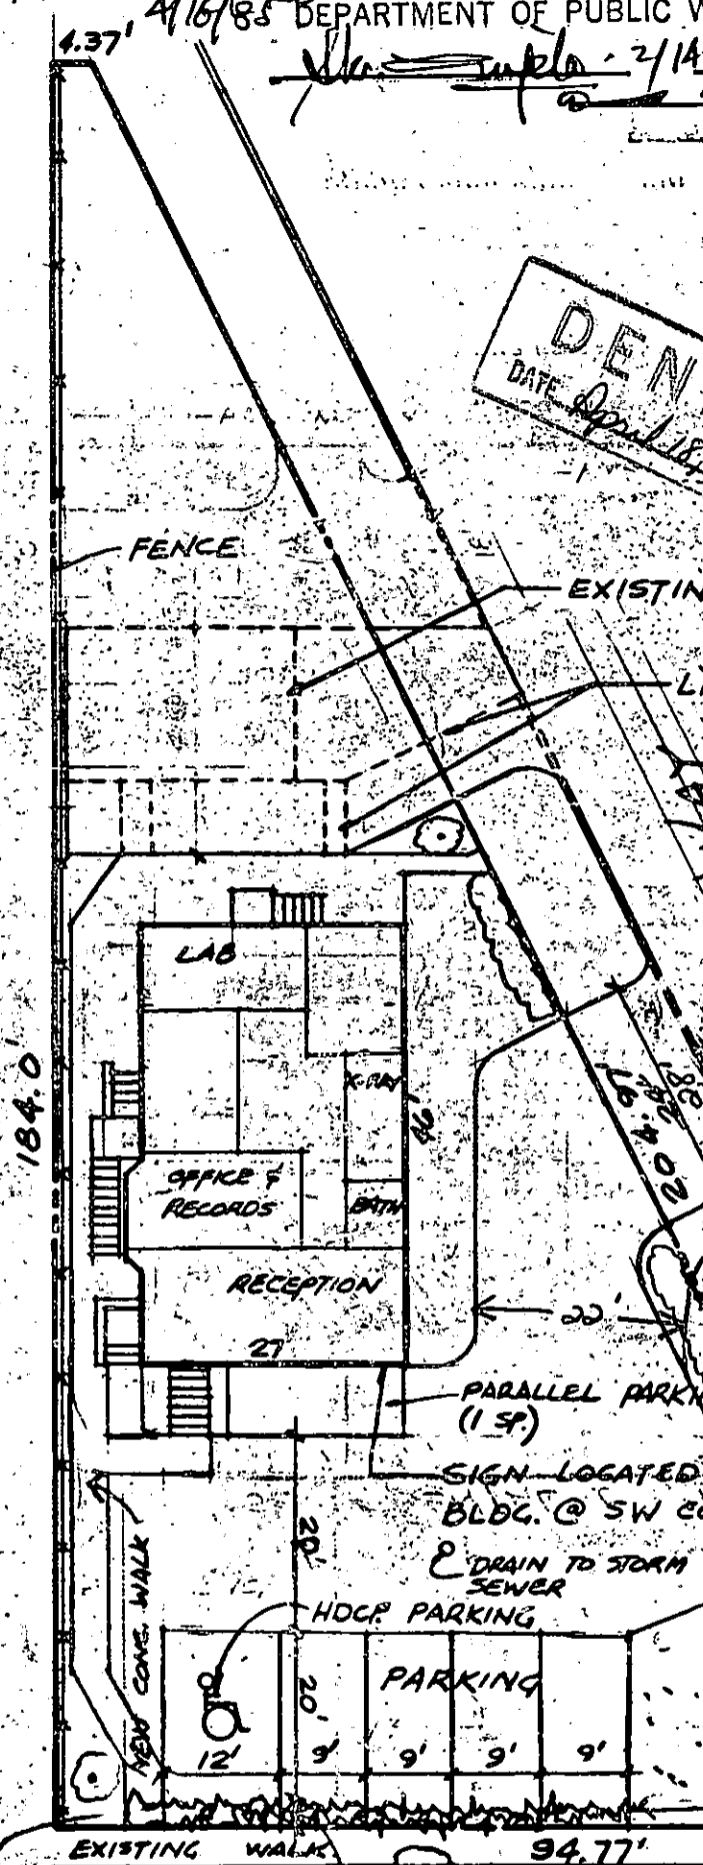

PRELIMINARY APPROVAL SURFACE WATER CONTROL
Conditions of Approval:
Zoning only
DATE 2/14/85
WATER MANAGEMENT ENGINEER JEFFERSON COUNTY
Revisions 4/15/85

NEW CURB CUT
Bushes 3'-6" high
NORTH
1" = 20'

Bushes 3'-6" high

THIRD STREET

RECEIVED
FEB 14 1985
APR 16 1985
LOUISVILLE & JEFFERSON COUNTY PLANNING COMMISSION

CHANGE IN ZONING - R-6 TO R-6
1 1/2 STORY OFFICE BLDG.
PROPOSED USE: DENTAL OFFICE

9 17 - 85