

CHECKED BY:	JMB
DRAWN BY:	JMB
DOCUMENT DATE:	01/19/15
PROTO TYPE:	195 SC
PROTO CYCLE:	12/19/14




FOR PERMIT ONLY
- NOT FOR
CONSTRUCTION

SHEET INCLUDED FOR
INFORMATION ONLY.

THIS SHEET IS A COPY
OF EXISTING AS-BUILT
CONDITIONS PREPARED
BY FREELAND AND
KAUFMAN, INC. DRAWING
ON 08/21/06 TITLE
"OVERALL SITE PLAN"
AND SHEET NO. 17
PROVIDED BY WALMART.
THE ARCHITECT OF
RECORD HAS MADE ONLY
SIGNAGE MODIFICATIONS
TO THE INFORMATION
CONTAINED AND CANNOT
BE HELD RESPONSIBLE
FOR THE ACCURACY OF
THE EXISTING CONDITIONS
ILLUSTRATED.

SITE
PLAN

SHEET:
SITE

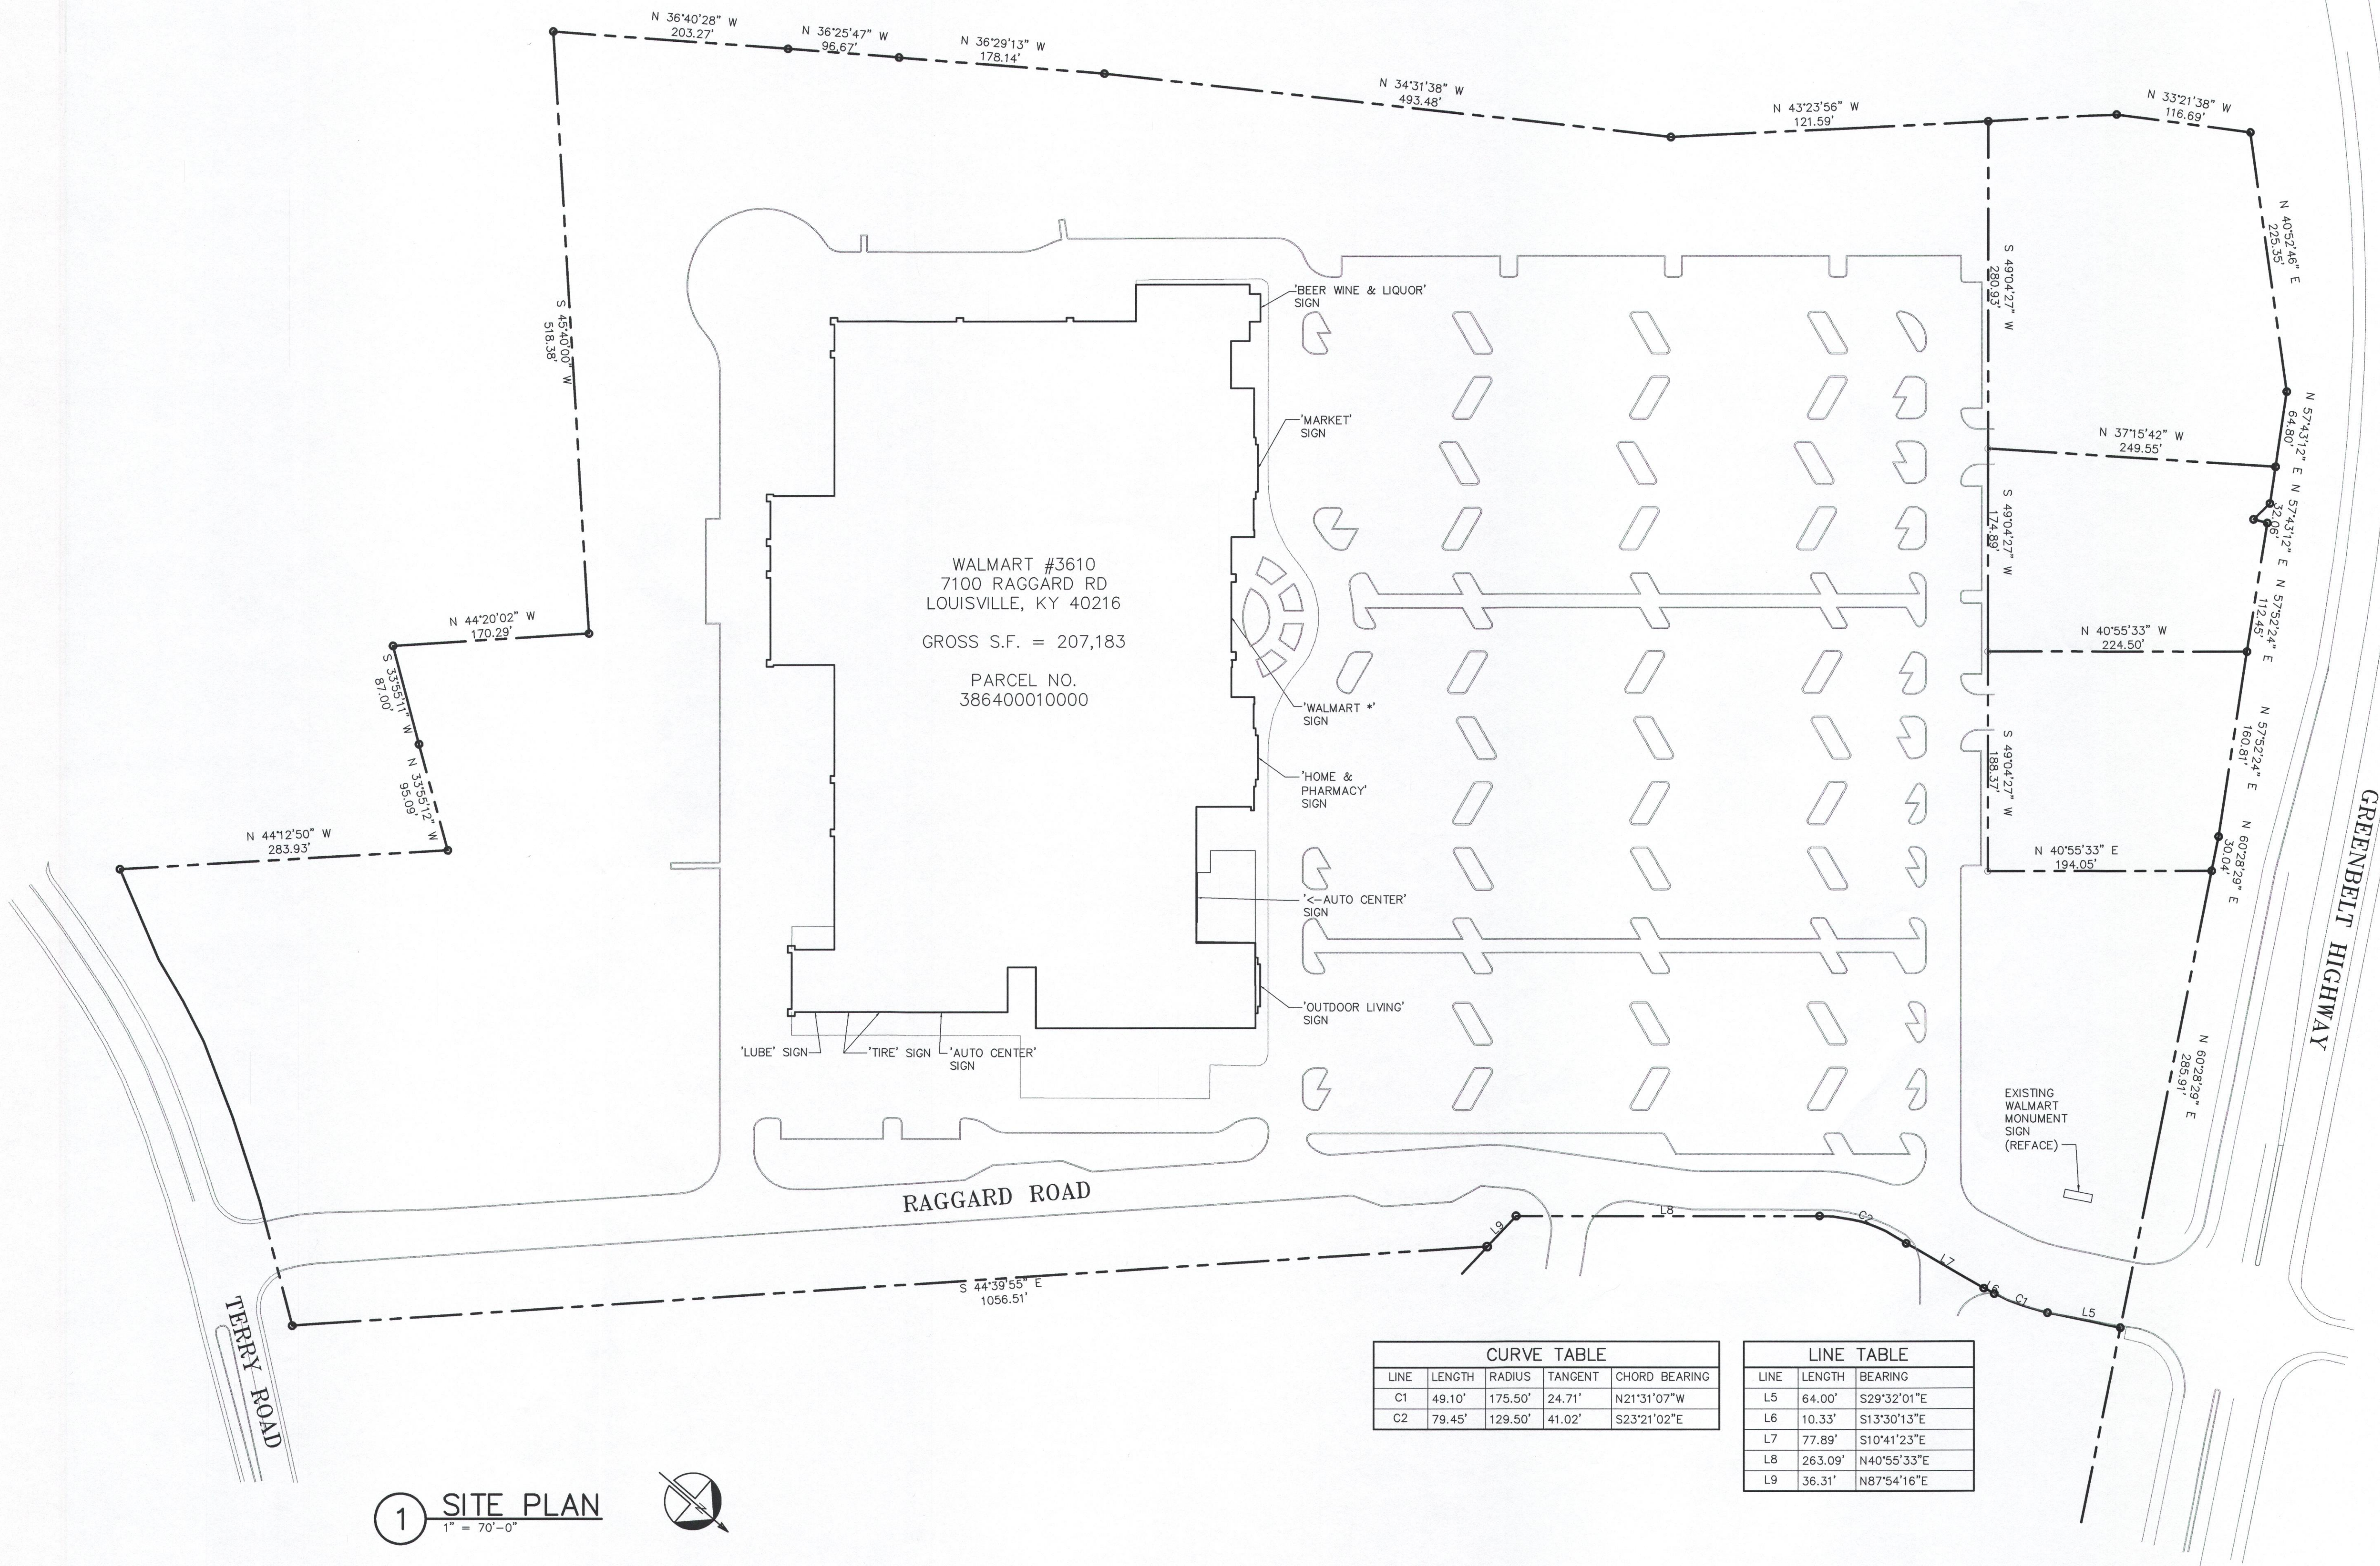

CURVE TABLE				
LINE	LENGTH	RADIUS	TANGENT	CHORD BEARING
C1	49.10'	175.50'	24.71'	N21°31'07"W
C2	79.45'	129.50'	41.02'	S23°21'02"E

LINE TABLE		
LINE	LENGTH	BEARING
L5	64.00'	S29°32'01"E
L6	10.33'	S13°30'13"E
L7	77.89'	S10°41'23"E
L8	263.09'	N40°55'33"E
L9	36.31'	N87°54'16"E