

As Built Revision
 2-9-22


All Deck Post
 are sitting on
 Existing Slab
 and attached to Existing Slab
 with Simpson Strong ties

1st Floor Beam are Every 4FT
 and Com at 16' Flom
 Home
 Floor Beam are DBL 2x8
 Floor Joist at 2x6 @ 16" OC


Roof RAFTERS are 2x8
 Roof Ridge Beam is 2x10

Ledger Through
 Slab Around
 Concrete


Existing
 concrete slab
 Post Attached
 with Simpson
 Strong ties

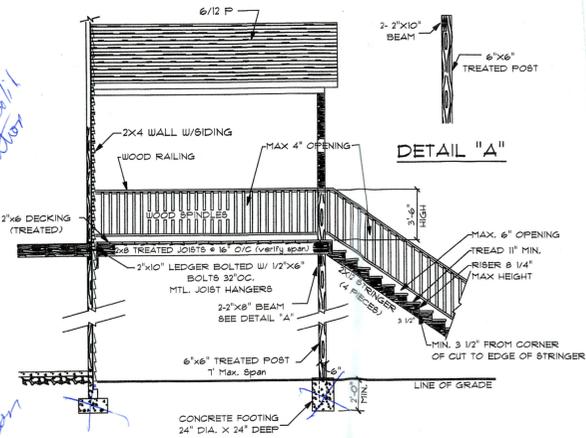

COVERED DECK DETAIL

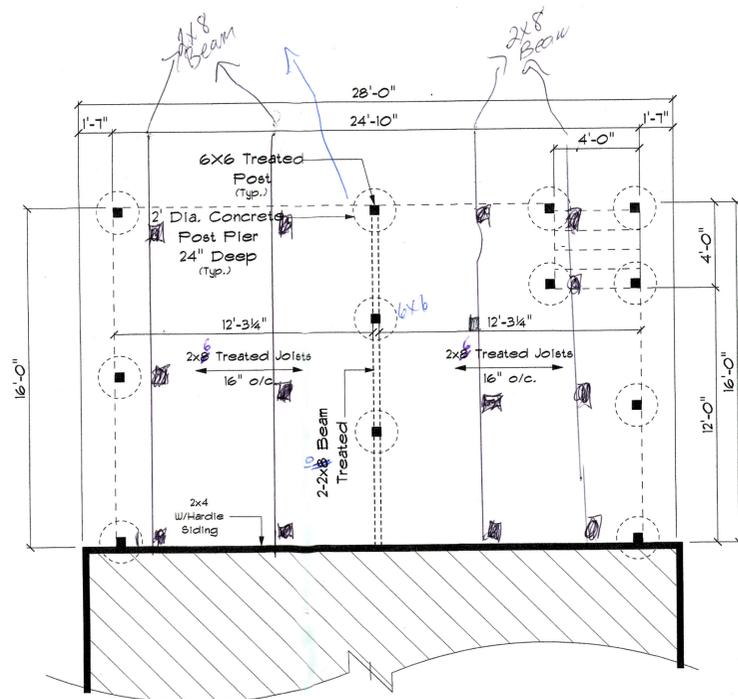


1st FLOOR PLAN

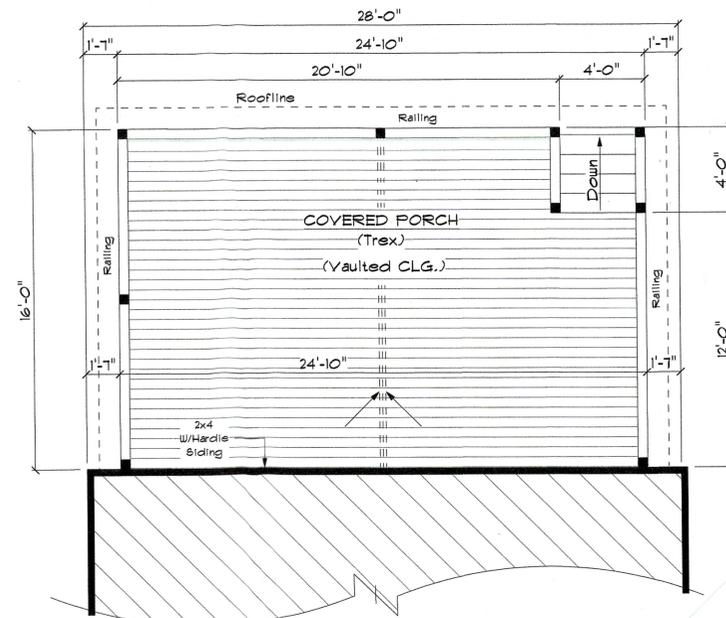


1st FLOOR PLAN


**COVERED PORCH PLAN FOR DONNIE FORAY
 3615 NORBOURNE BLVD.**

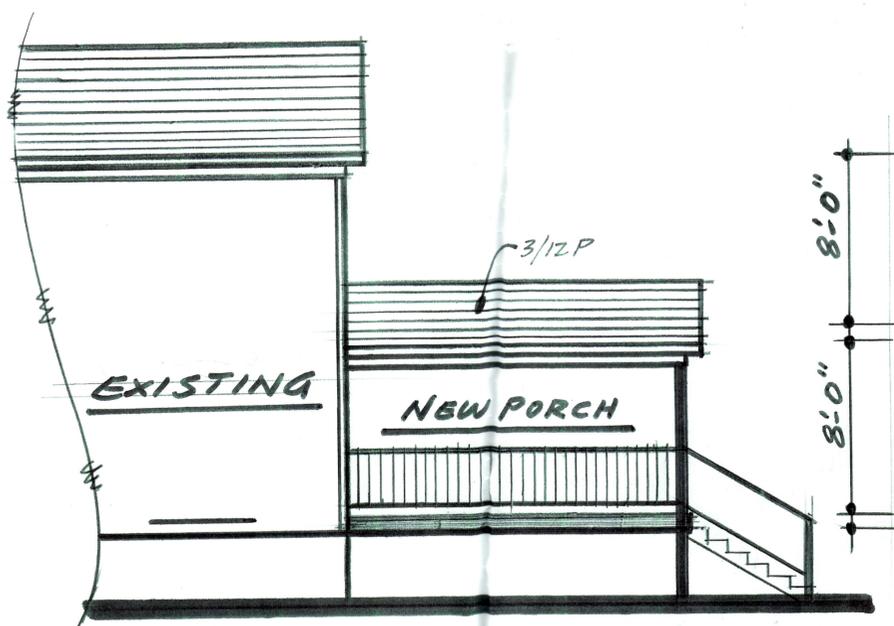

SIDE VIEW "A"

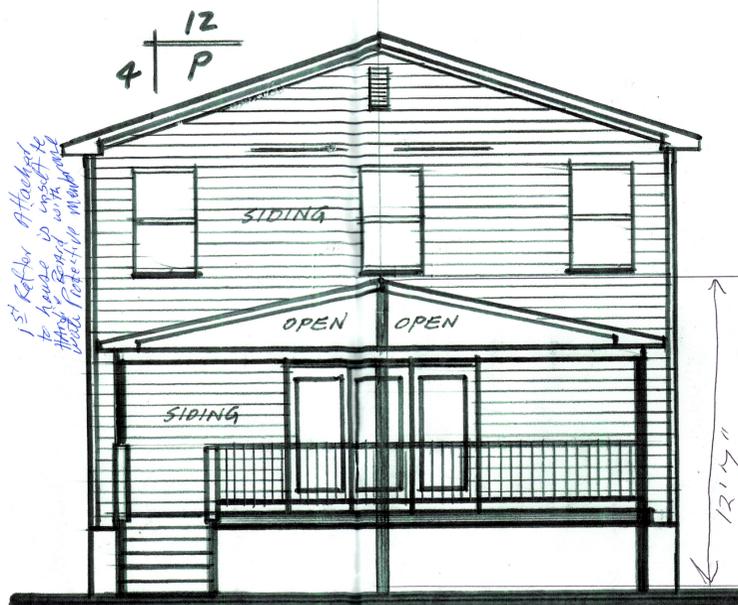

REAR VIEW

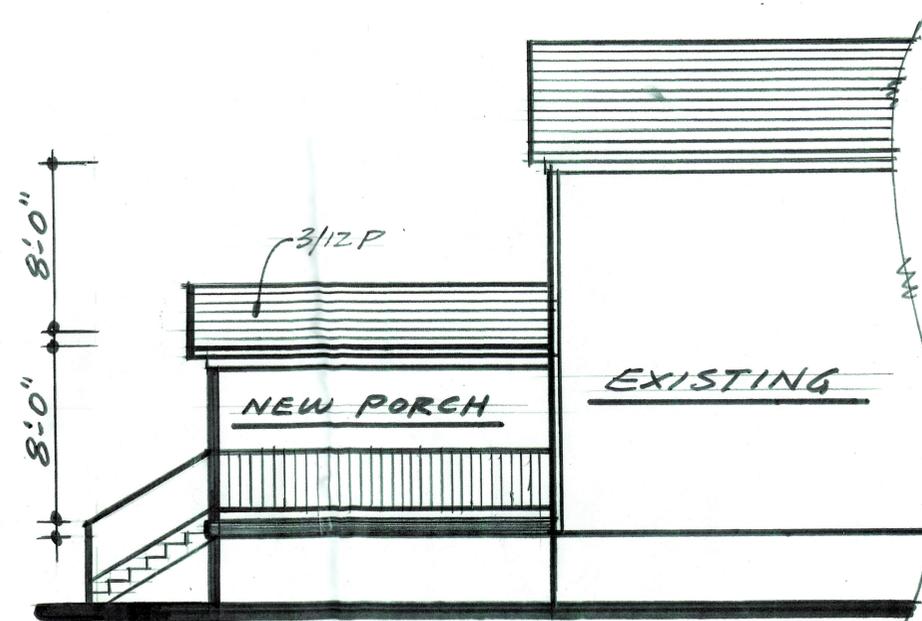

SIDE VIEW "B"

FORAY-DONNIE