
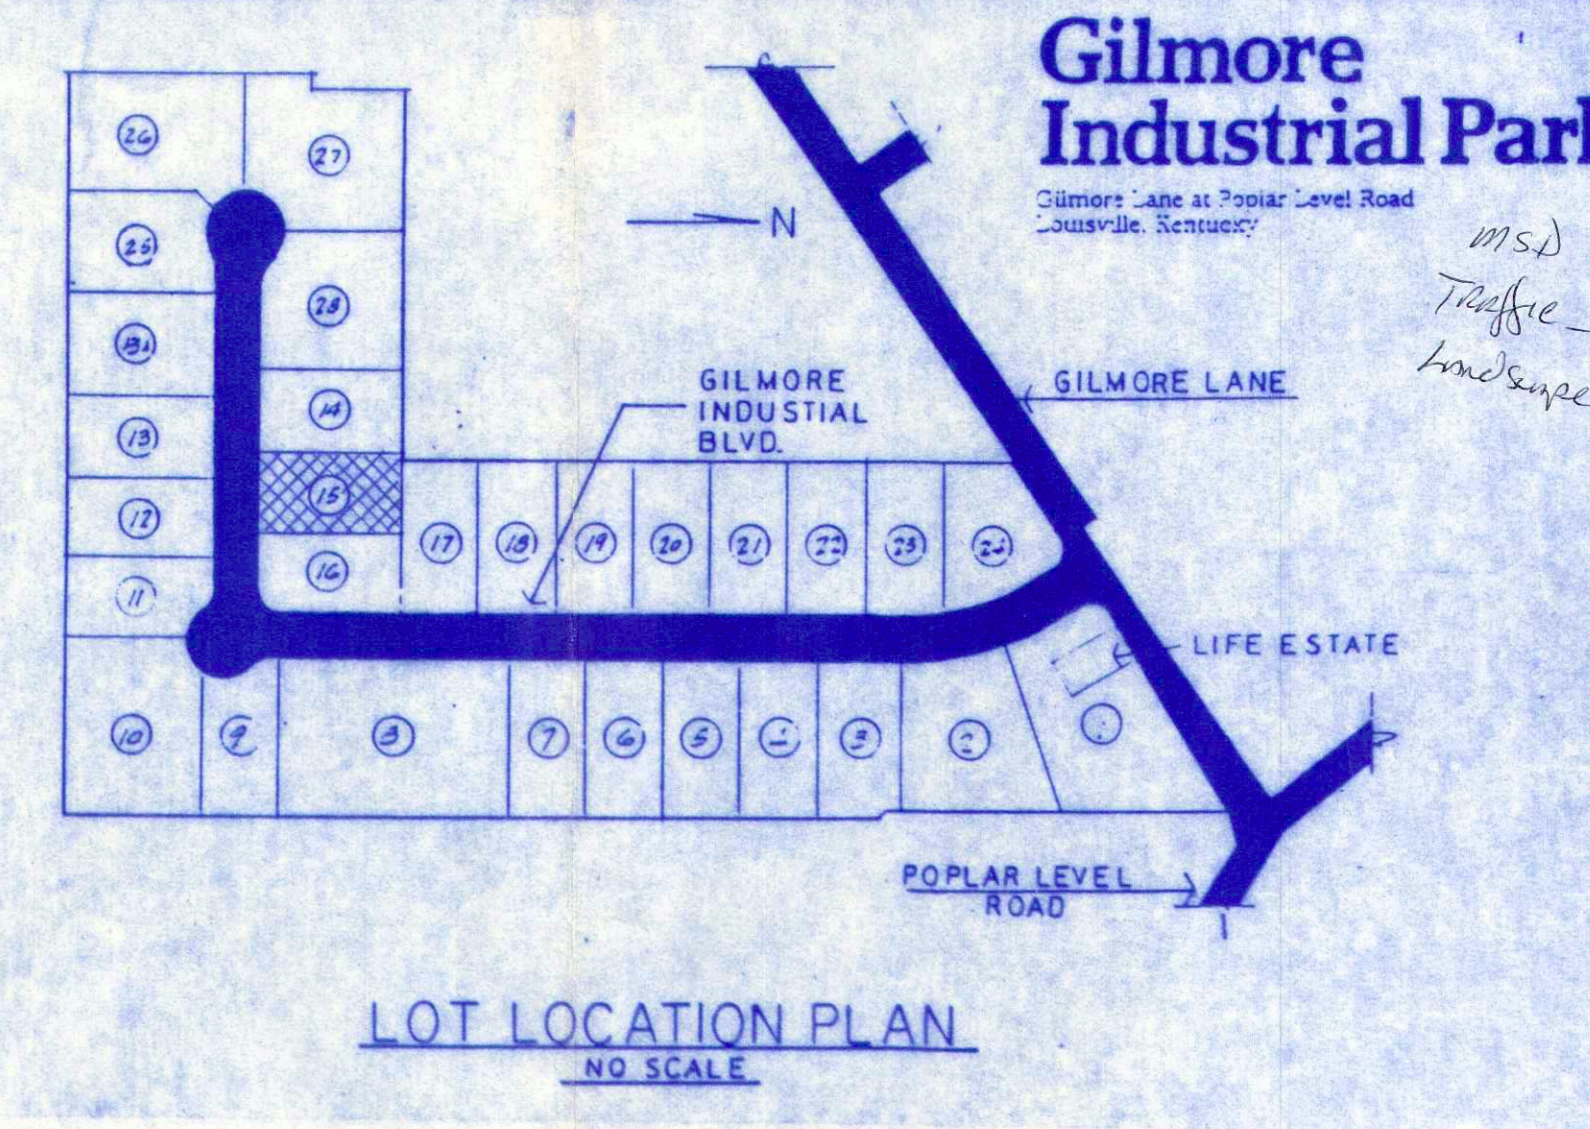
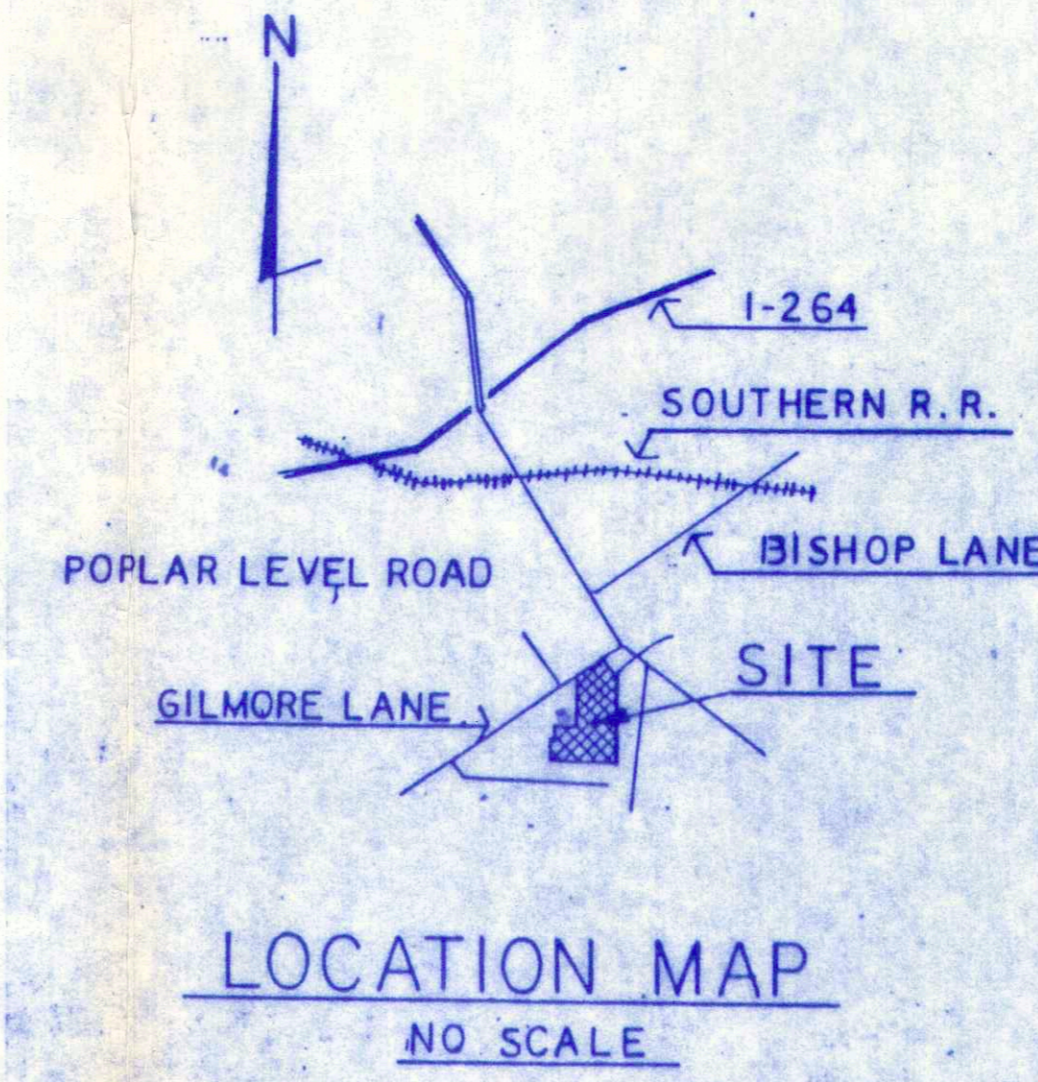



GENERAL NOTES

1. ALL WORK SHALL BE DONE IN STRICT ACCORDANCE WITH ALL APPLICABLE FEDERAL, OSHA, STATE AND LOCAL BUILDING CODES AND ZONING ORDINANCES.
2. ALL CONCRETE TO HAVE A MINIMUM COMPRESSIVE STRENGTH OF 3,500 PSI AT 28 DAYS.
3. MINIMUM CONCRETE PROTECTION FOR STEEL: 3/4" FOR SLABS, 1 1/2" FOR WALLS, AND 3" FOR FOOTINGS.
4. ALL DIMENSIONS SHOWN ON PLANS ARE ACTUAL.
5. MINIMUM DEPTH FOR ALL EARTH FOOTINGS SHALL BE 2'-0" BELOW FINISH GRADE. ALL FOOTINGS MUST BEAR ON UNDISTURBED EARTH, OR COMPACTED FILL APPROVED BY THE ARCHITECT.
6. THE CONTRACTOR AND OWNER SHALL PURCHASE AND MAINTAIN INSURANCE AS REQUIRED BY LAW PROTECTING THEM FROM CLAIMS SUCH AS CONTRACTOR'S LIABILITY, OWNERS LIABILITY AND PROPERTY INSURANCE BUT NOT LIMITED THERETO. A CERTIFICATE OF INSURANCE, ACCEPTABLE TO THE OWNER AND CONTRACTOR, SHALL BE FILED WITH EACH OTHER PRIOR TO START OF CONSTRUCTION.

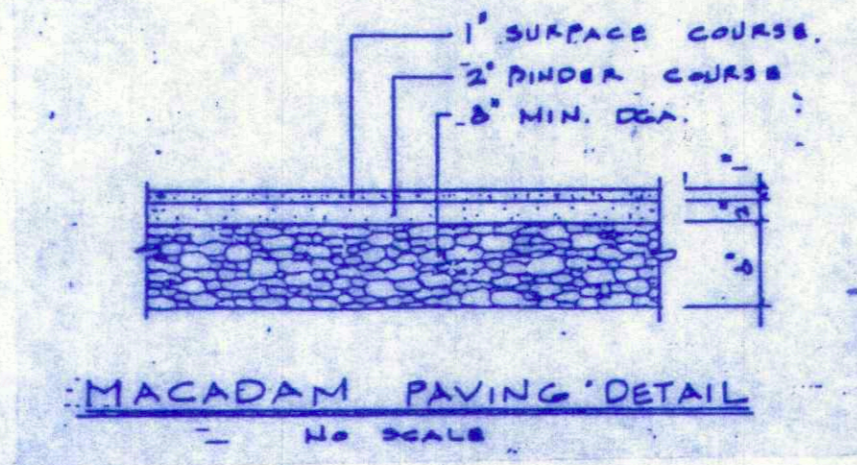

Gilmore Industrial Park
 Gilmore Lane at Poplar Level Road
 Louisville, Kentucky

MSD Traffic Landscape

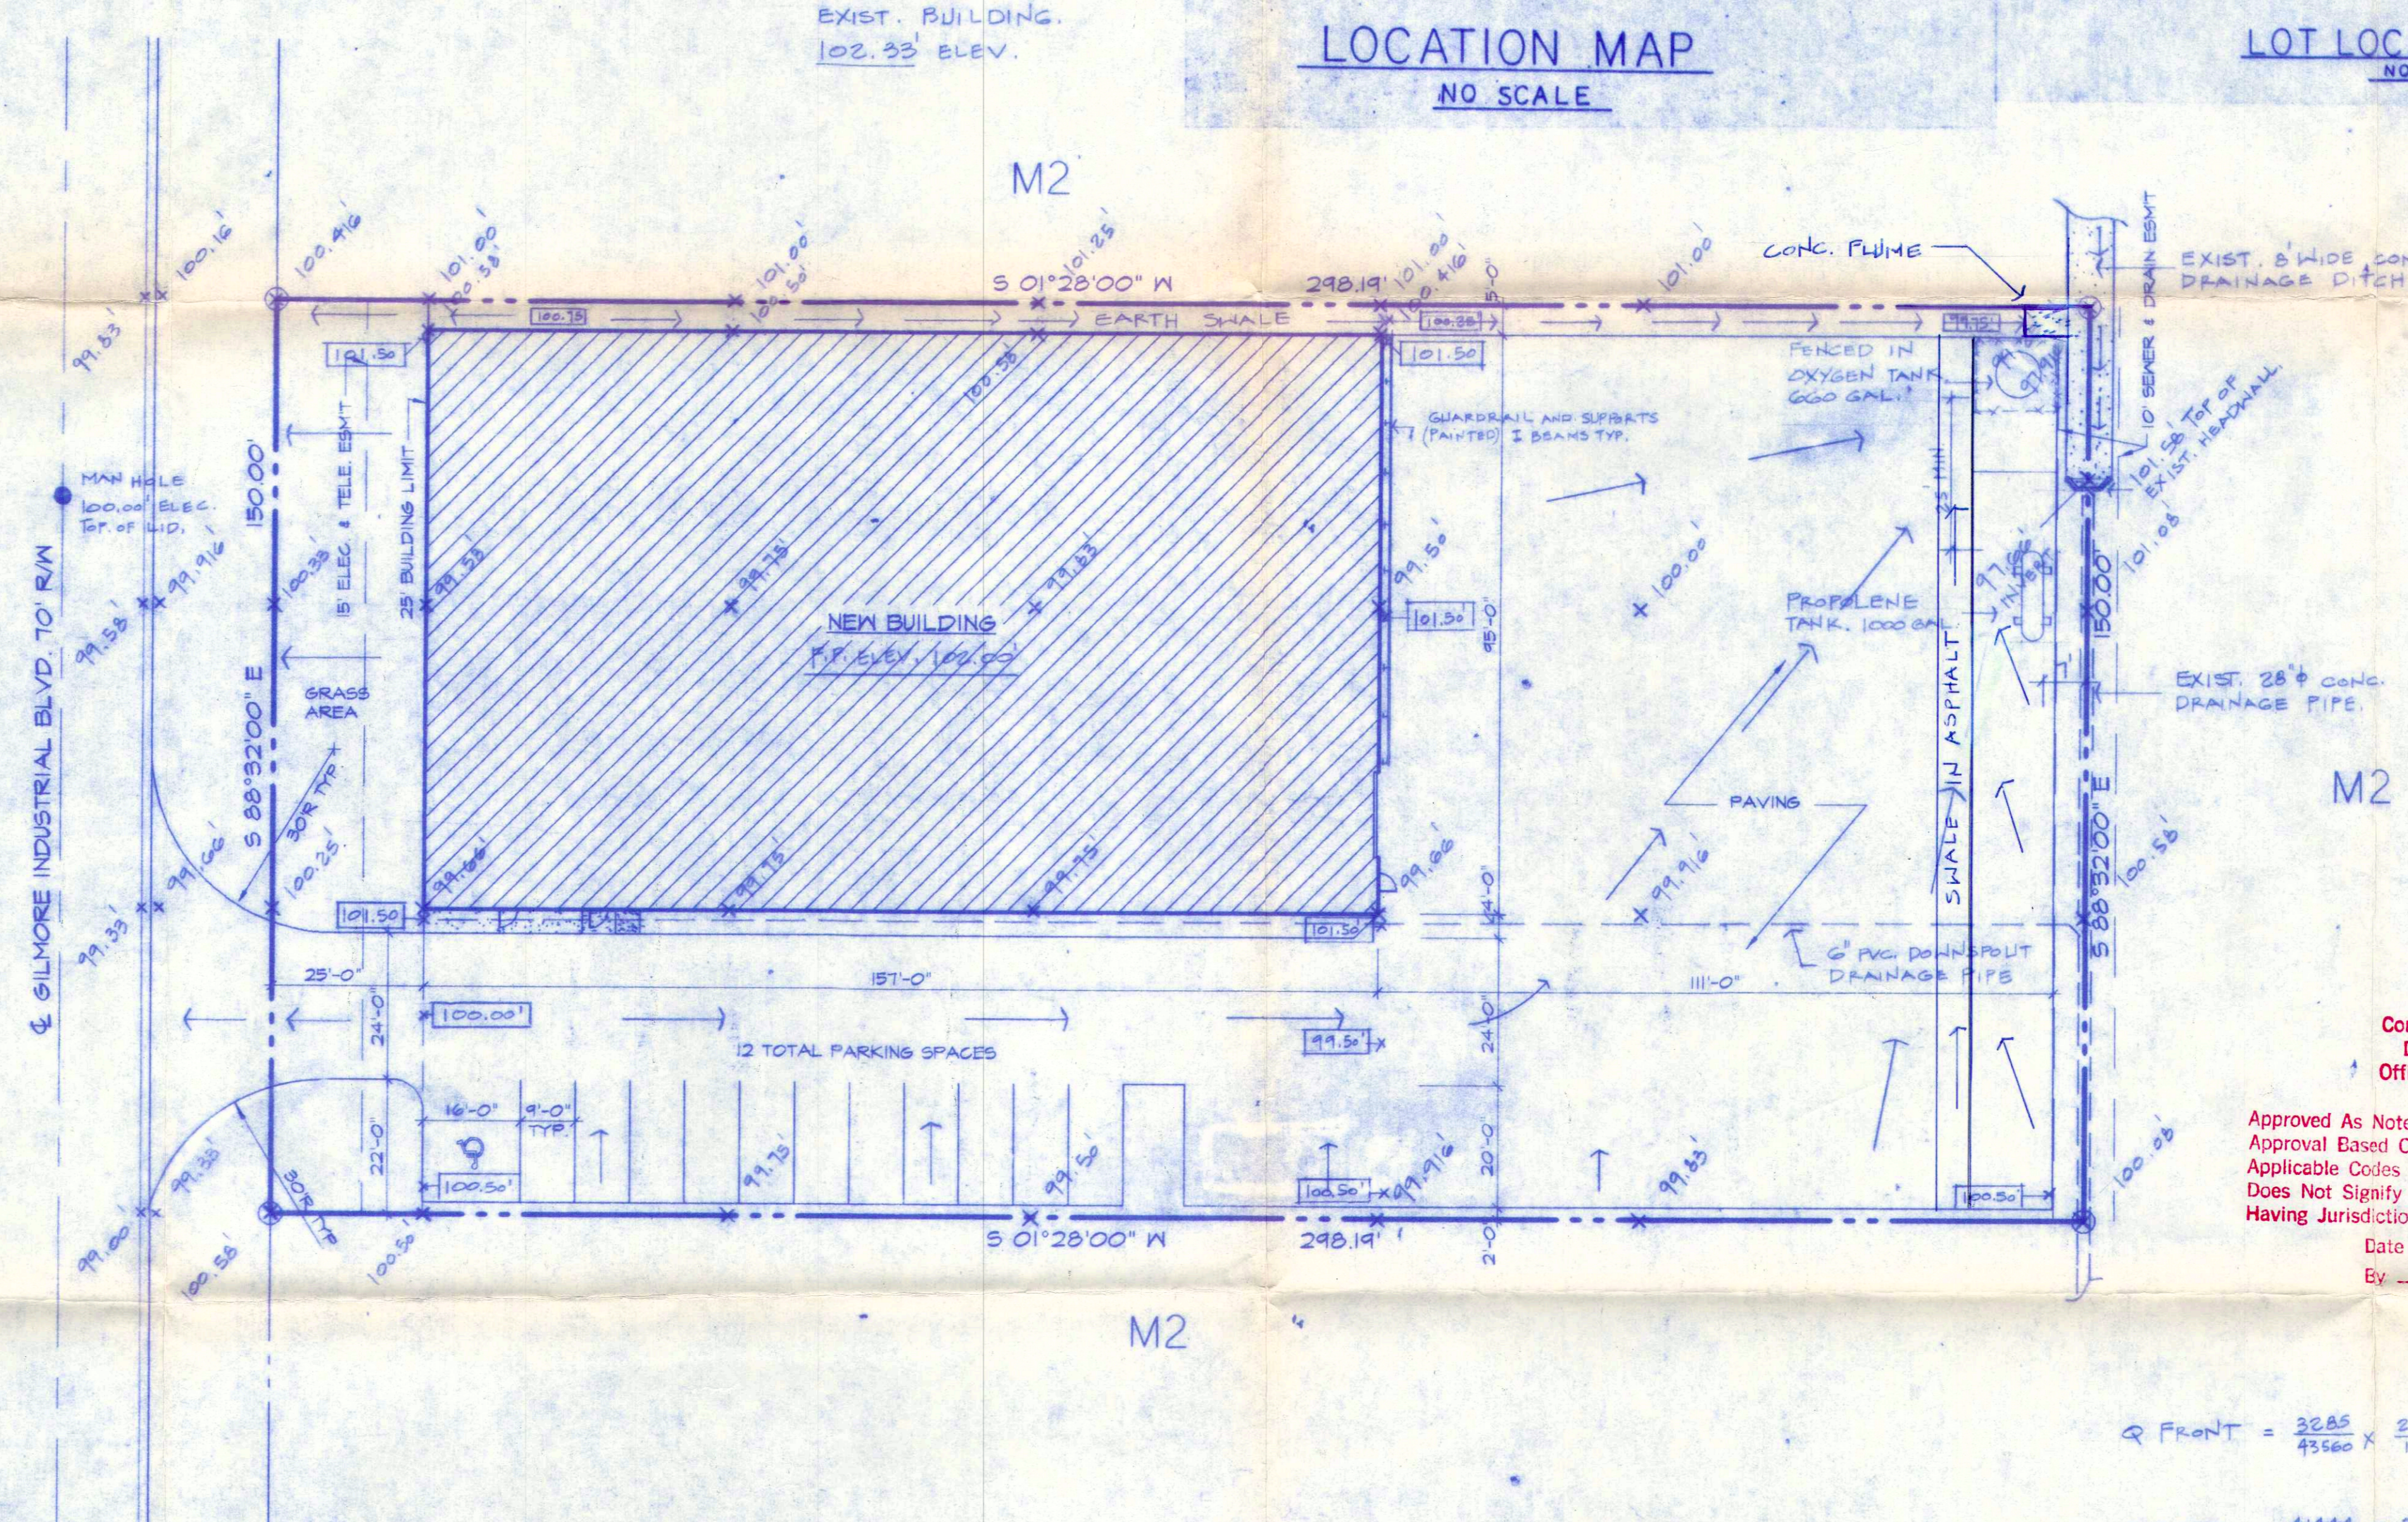

EXIST. BUILDING
 102.33' ELEV.

RECEIVED
 NOV 17 1992
 LOUISVILLE & JEFFERSON COUNTY
 PLANNING COMMISSION

Commonwealth of Kentucky
 Department of Housing
 Office of State Fire Marshal

Approved As Noted: *[Signature]*
 Approval Based On Compliance With
 Applicable Codes And Standards And
 Does Not Signify Approval Of Others
 Having Jurisdiction.

Date: 11/16/92
 By: *[Signature]*

Delet # 9-116-86

$Q \text{ FRONT} = \frac{3285}{43560} \times \frac{29}{12} (.35) = .006 \text{ cfs}$

$Q \text{ REAR} = \frac{4144}{43560} \times \frac{29}{12} (.65) = 0.15 \text{ cfs}$

NO RETENTION REQUIRED!

PARKING DATA

OFFICE	650 SQ. FT.	2 SPACES
WAREHOUSE	4 EMPLOYEES	3 SPACES
		5 SPACES REQ'D.
TOTAL SPACES PROVIDED 12		

SITE PLAN

SCALE: 1"=20'

LEGEND


- EXISTING GRADE
- NEW GRADE

REVISIONS	BY

NEW FACILITY FOR:
NEILL-LAVIELLE STEEL
 GILMORE INDUSTRIAL BLVD.
 LOUISVILLE, KENTUCKY

Gilbert W. Campbell, Associates
 A.I.A. Architect Interior Design

7383 Pete Andres Road
 Florida Knobs, IN 47119
 (812) 923-7438
 FAX (812) 923-3406

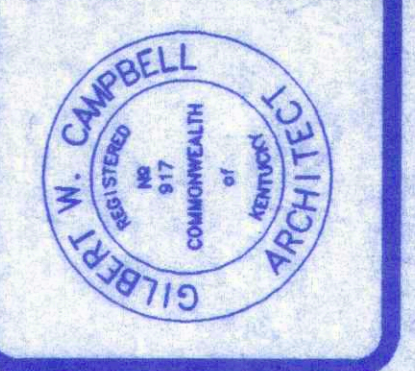

RECEIVED
 NOV 17 1992
 LOUISVILLE & JEFFERSON COUNTY
 PLANNING COMMISSION

DRAWN	K.M. & D.L.S.
CHECKED	G.W.C.
DATE	OCT 1 1992
SCALE	
JOB NO.	
SHEET	A-1
of 11	SHEETS

9-116-86