


NOTE:
Easement to Metropolitan Sew Dist recorded
in D.B. 3338 P. 156 does not affect this property

NOTE:
Bearing System For Survey
Controlled From the North-east
Line of Tract.



NOTE:
Total Area of Tracts, including Breitenstein Ave.,
but excluding Lot 45 Lynnview Sub #1 is 85.555 acres.

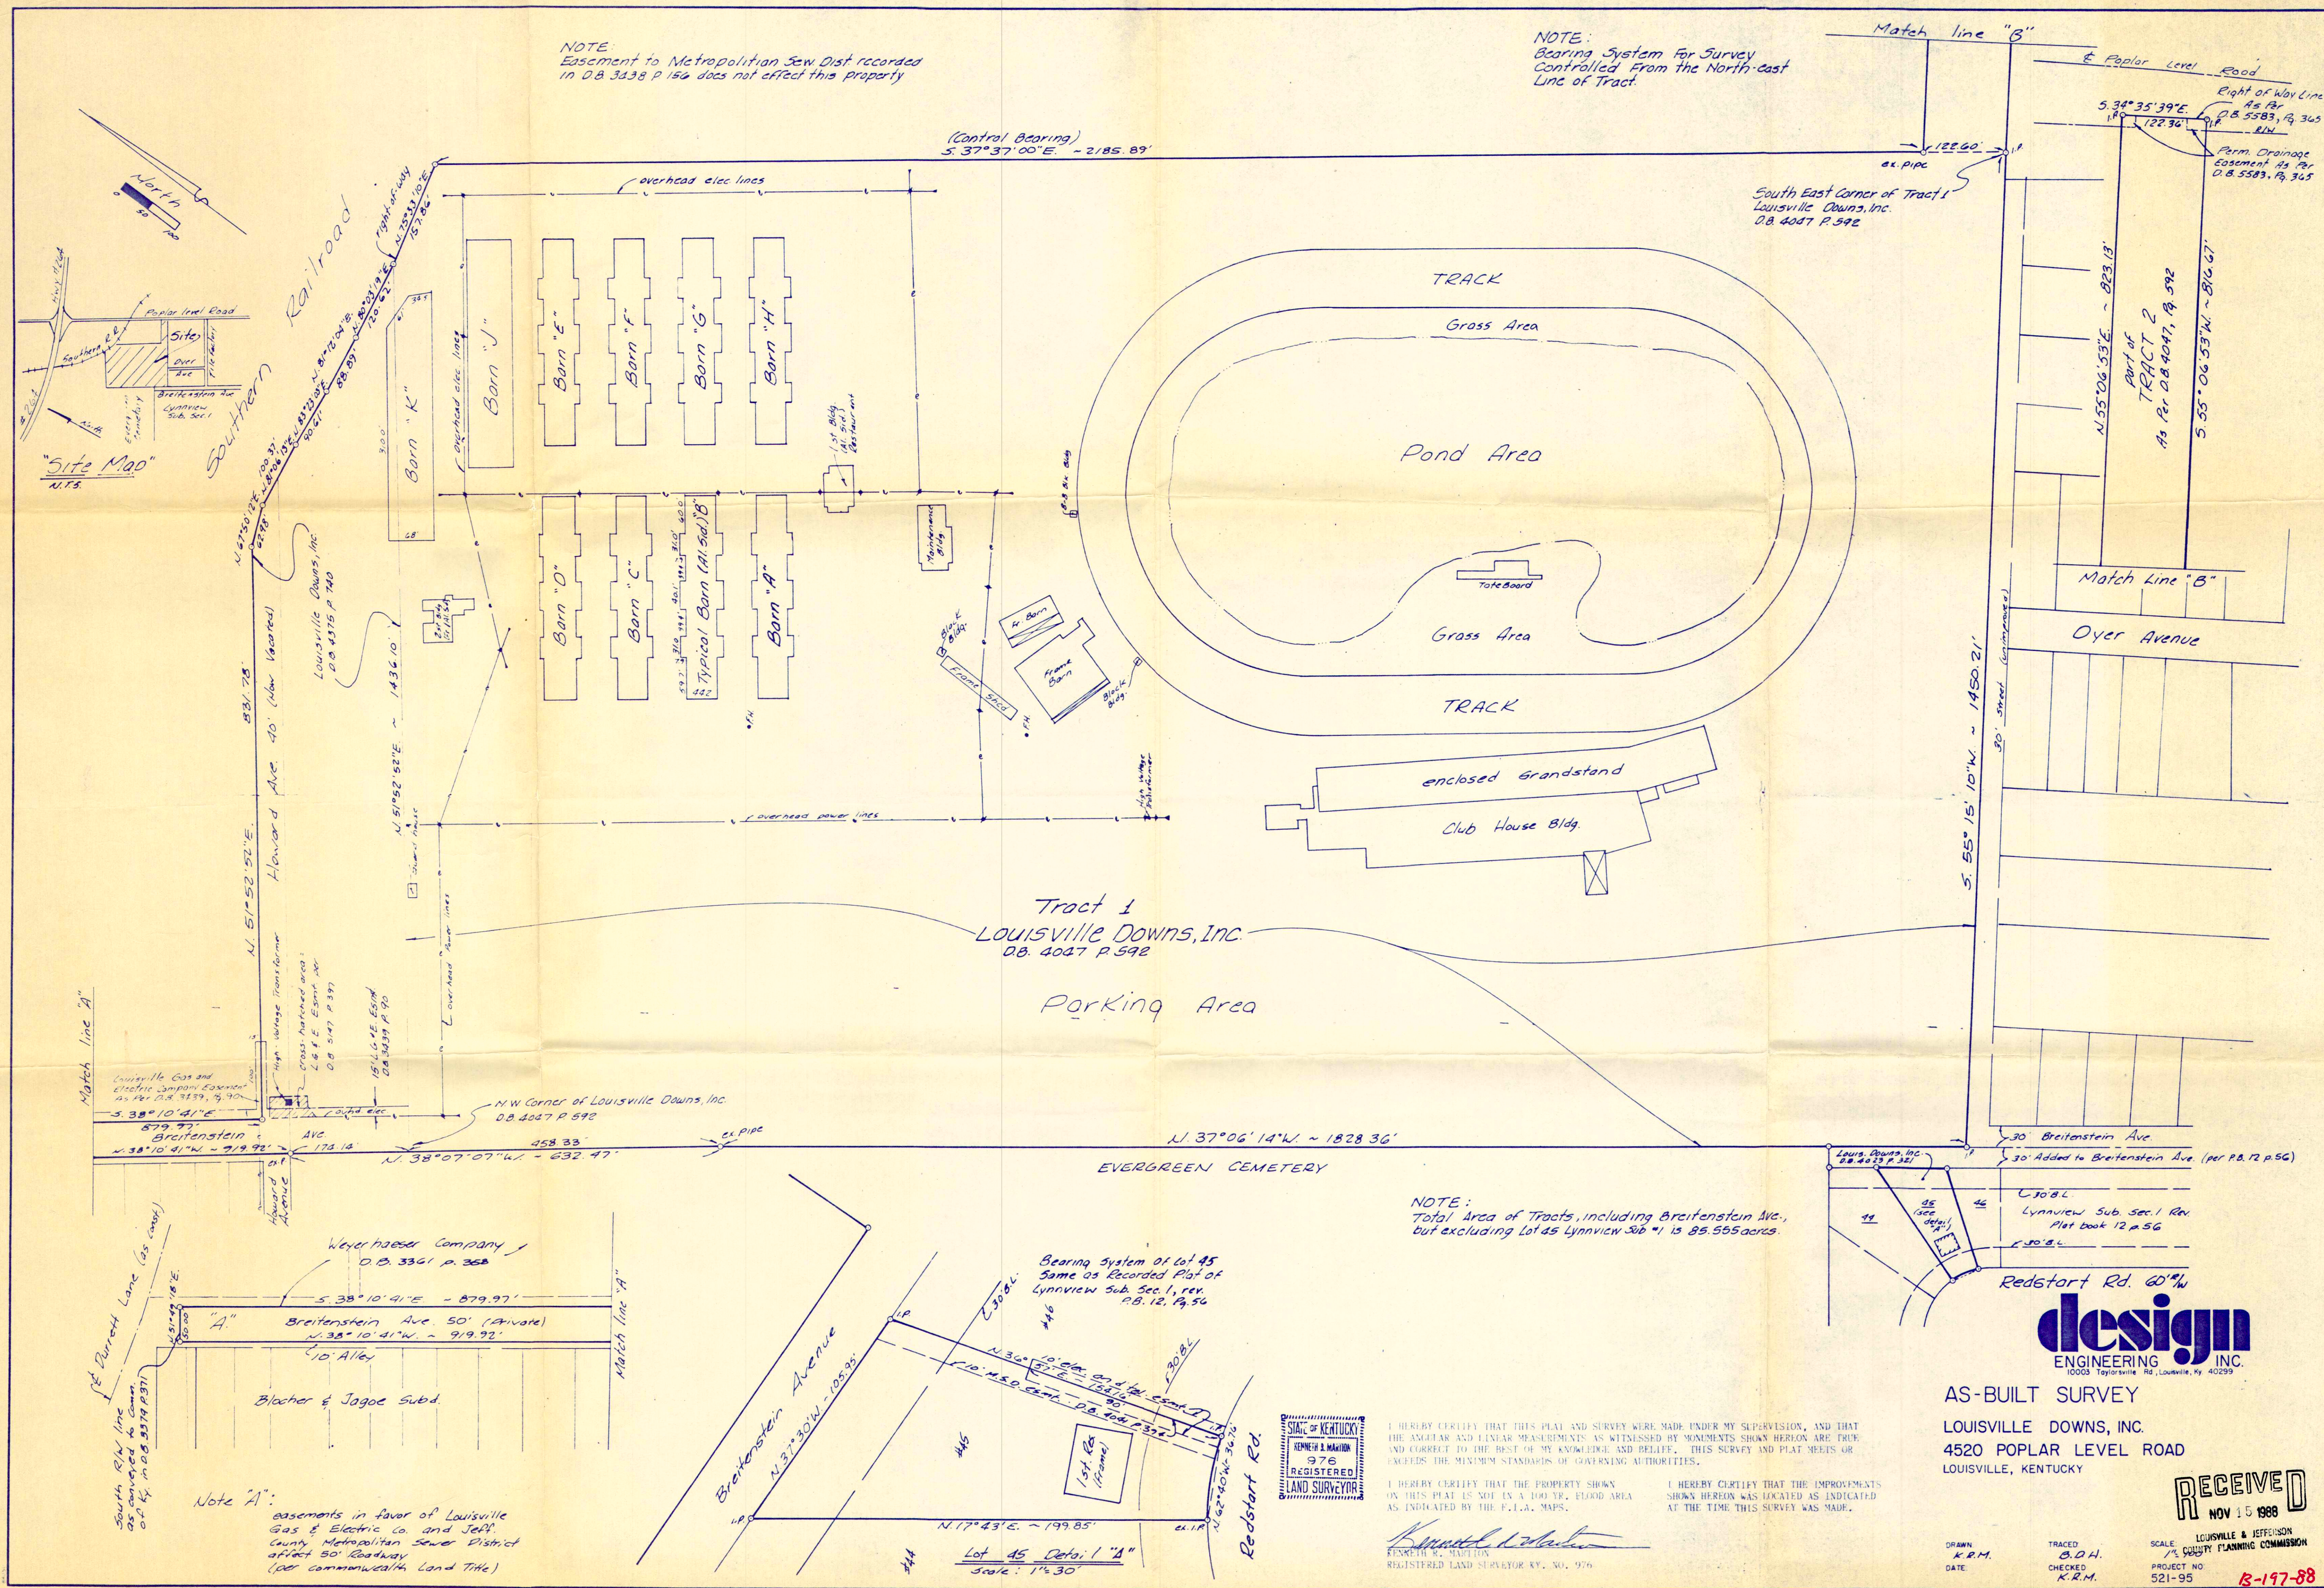

I HEREBY CERTIFY THAT THIS PLAN AND SURVEY WERE MADE UNDER MY SUPERVISION, AND THAT THE ANGULAR AND LINEAR MEASUREMENTS AS WITNESSED BY MONUMENTS SHOWN HEREON ARE TRUE AND CORRECT TO THE BEST OF MY KNOWLEDGE AND BELIEF. THIS SURVEY AND PLAN MEETS OR EXCEEDS THE MINIMUM STANDARDS OF GOVERNING AUTHORITIES.

I HEREBY CERTIFY THAT THE PROPERTY SHOWN ON THIS PLAN IS NOT IN A 100 YR. FLOOD AREA AS INDICATED BY THE F.I.A. MAPS.

I HEREBY CERTIFY THAT THE IMPROVEMENTS SHOWN HEREON WAS LOCATED AS INDICATED AT THE TIME THIS SURVEY WAS MADE.

Kenneth R. Marton
KENNETH R. MARTON
REGISTERED LAND SURVEYOR KY. NO. 976

design
ENGINEERING INC.
10003 Taylorsville Rd., Louisville, Ky. 40299

AS-BUILT SURVEY
LOUISVILLE DOWNS, INC.
4520 POPLAR LEVEL ROAD
LOUISVILLE, KENTUCKY

RECEIVED
NOV 15 1988

LOUISVILLE & JEFFERSON COUNTY PLANNING COMMISSION
PROJECT NO. 521-95
B-197-88